




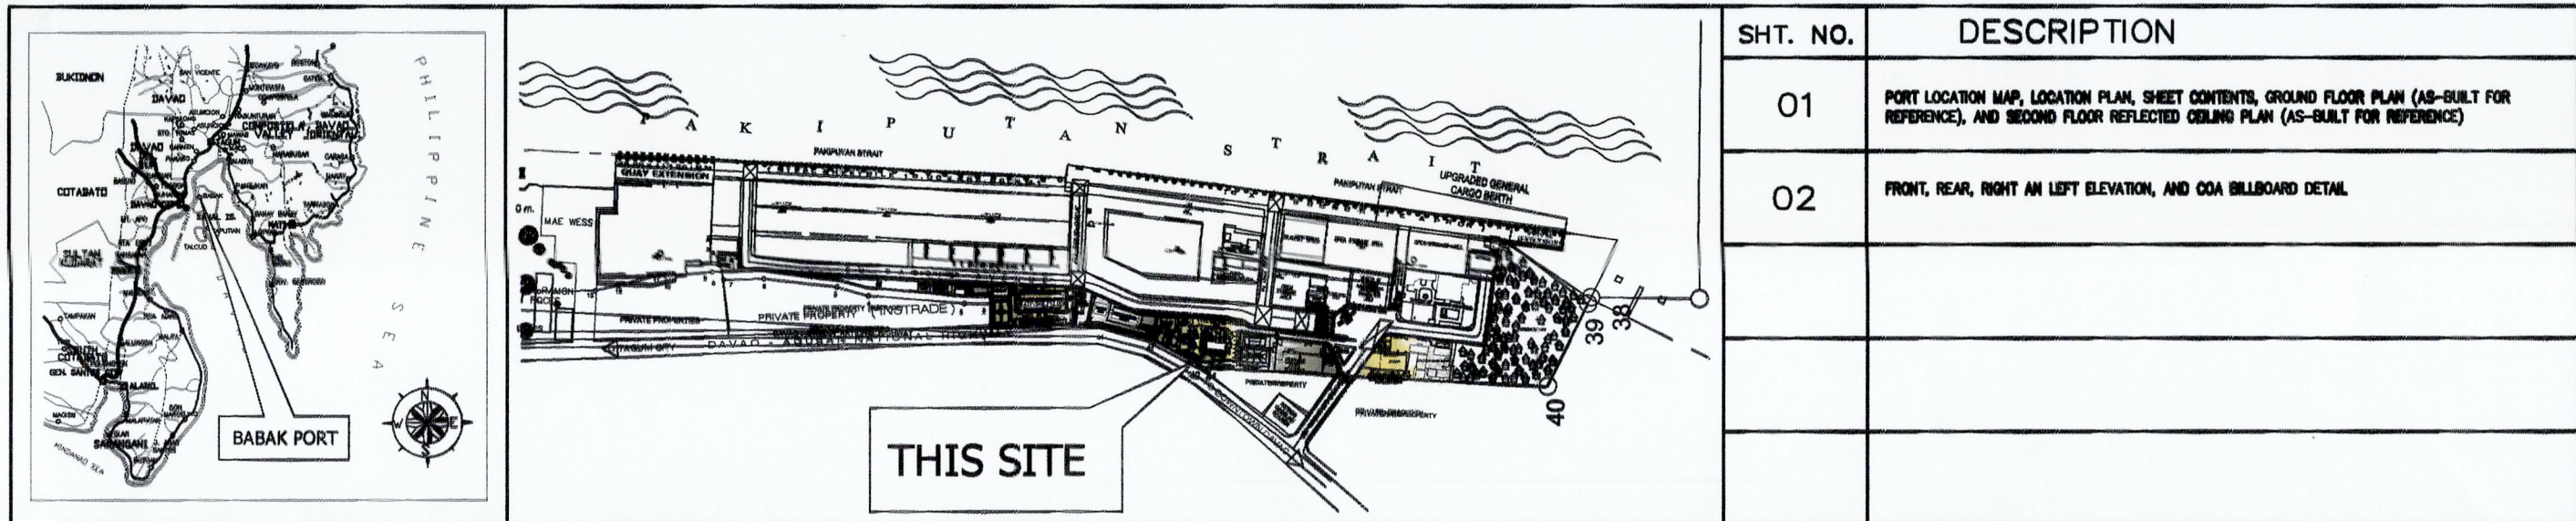




01.1 PORT LOCATION MAP SCALE 1:1000 METERS 01.2 LOCATION PLAN SCALE 1:1000 METERS 01.3 SHEET CONTENTS SCALE 1:100 METERS

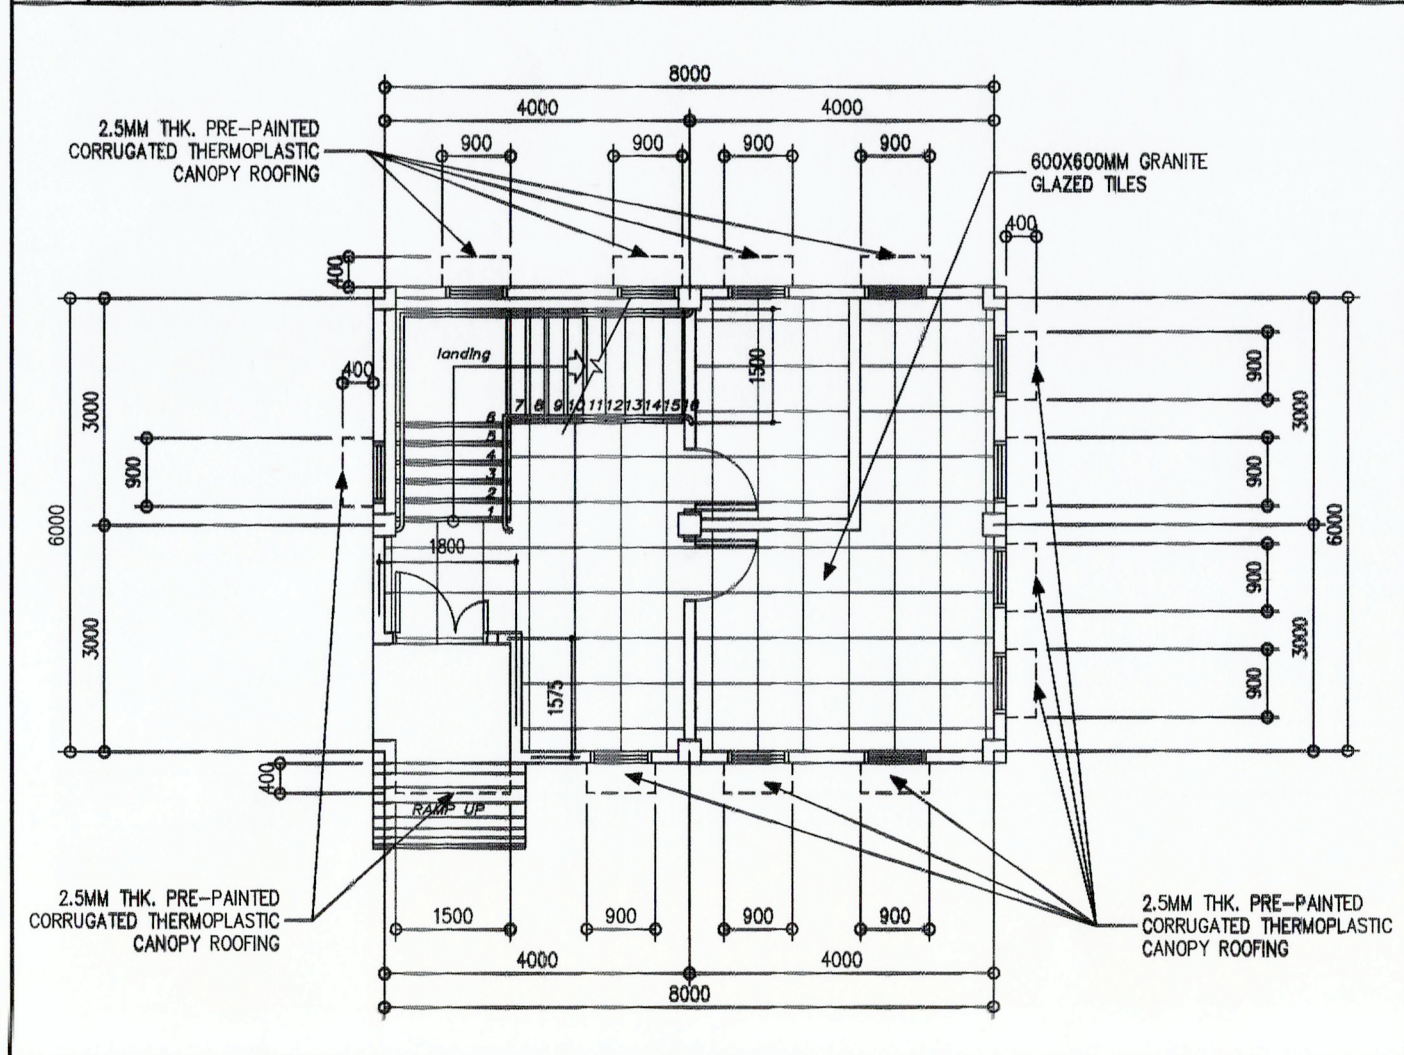


01.4 GROUND FLOOR PLAN (AS-BUILT FOR REFERENCE) SCALE 1:100 METERS

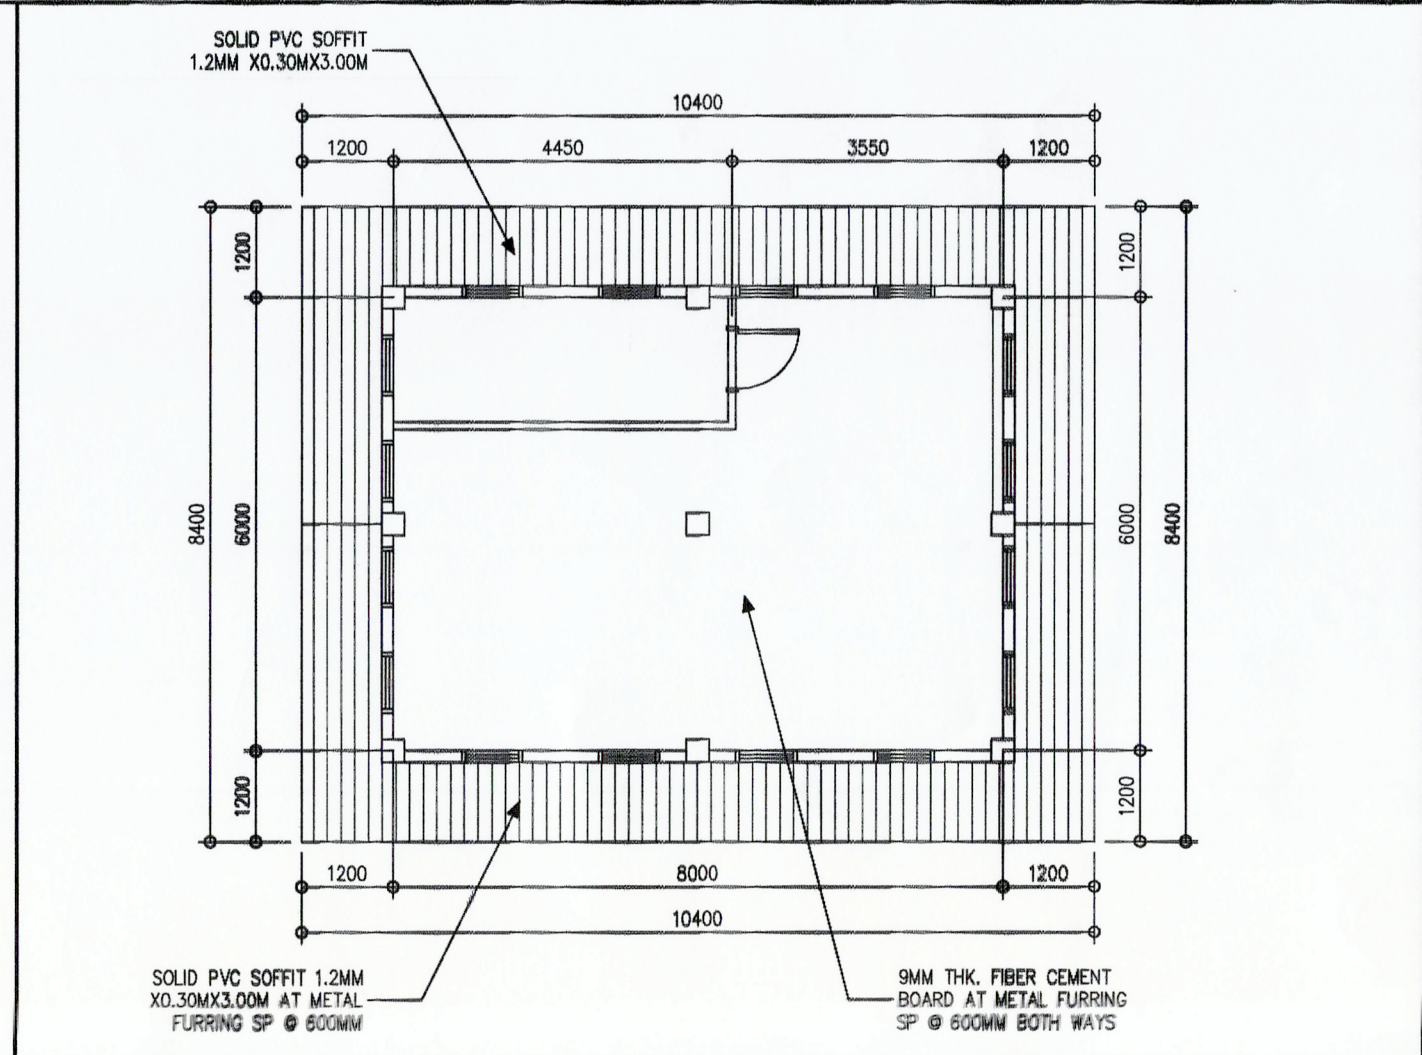


01.5 SECOND FLOOR REFLECTED CEILING PLAN (AS-BUILT FOR REFERENCE) SCALE 1:100 METERS

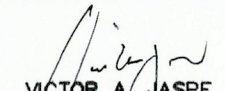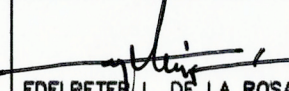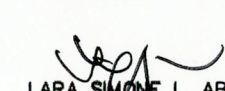	PREPARED BY:  VICTOR A. JASPE ENGINEERING ASSISTANT-A	CHECKED AND REVIEWED BY:  EDELPELTER L. DE LA ROSA SUPERVISING ENGINEER A	RECOMMENDING APPROVAL BY:  LARA SIMONE L. ABA ACTING ESD MANAGER	APPROVED BY:  ANALEE G. AGUILA PORT MANAGER	OWNER: ANALEE G. AGUILA PORT MANAGER	PROJECT TITLE: MAINTENANCE OF ESD TOOLROOM BUILDING, SASA PORT	REVISIONS DATE REMARKS	SHEET NO. OF 01 2
	SHEET CONTENTS: PORT LOCATION MAP, LOCATION PLAN, SHEET CONTENTS, GROUND FLOOR PLAN (AS-BUILT FOR REFERENCE), AND SECOND FLOOR REFLECTED CEILING PLAN (AS-BUILT FOR REFERENCE)					LOCATION: KM. 10, PORT AREA, SASA, DAYAO CITY	NO. PROJECT DATE DRAWN	ADDENDUM DATE REMARKS


CAD FILE: WESd-server\esd\00 - ESD-PORTESD FileServer\2025 Projects (PLOT)\2025-08_SVRM-2025-08 - Sasa - Maintenance of ESD Toolroom\2024-SAS-D-00_Maintenance ESD Toolroom.dwg
LAST PLOTTED: 10/29/2024 2:48:34 PM
PLOT STYLE: monochrome.ctb

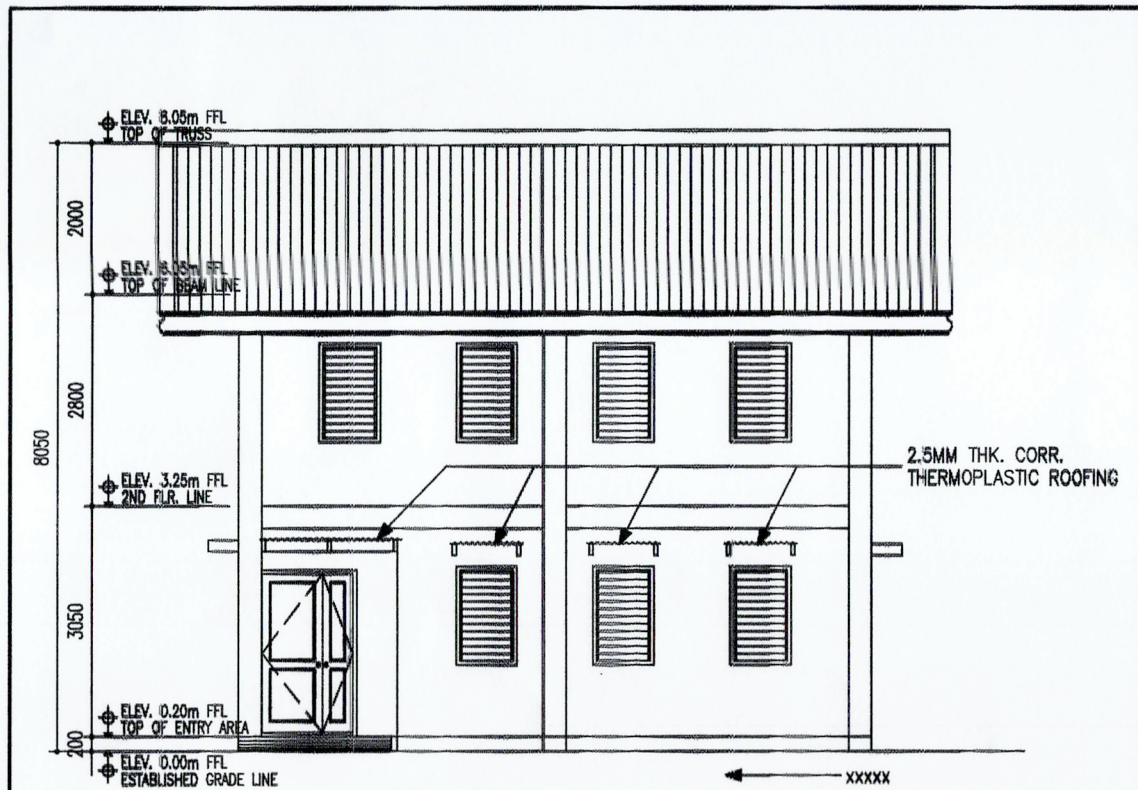


02.1 FRONT ELEVATION
SCALE 1:100 METERS

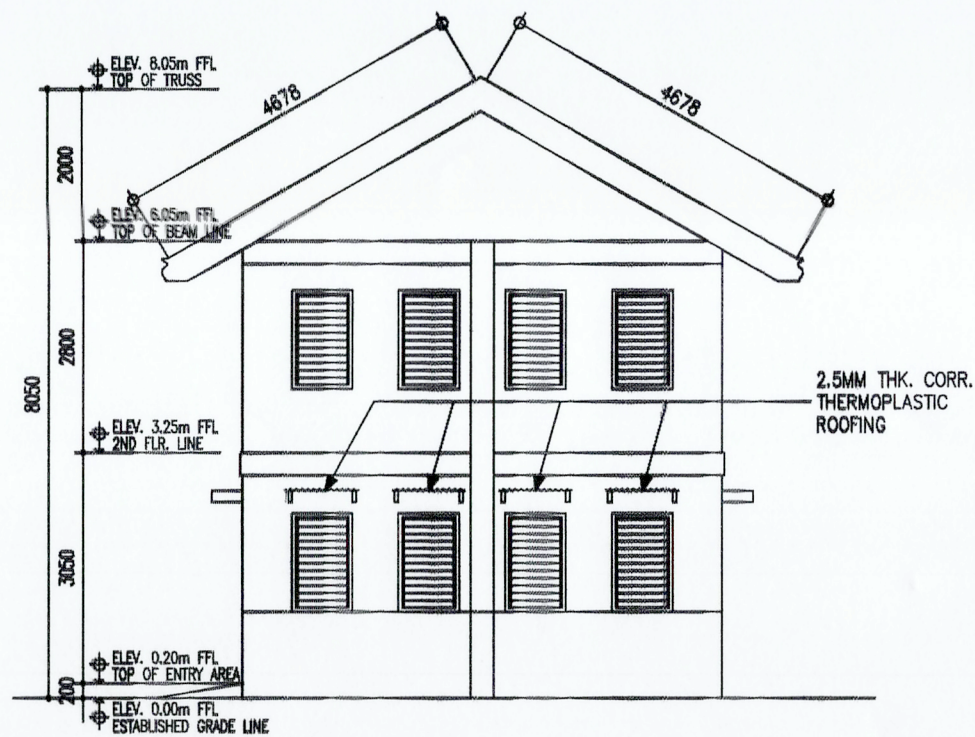


02.2 RIGHT SIDE ELEVATION
SCALE 1:100 METERS

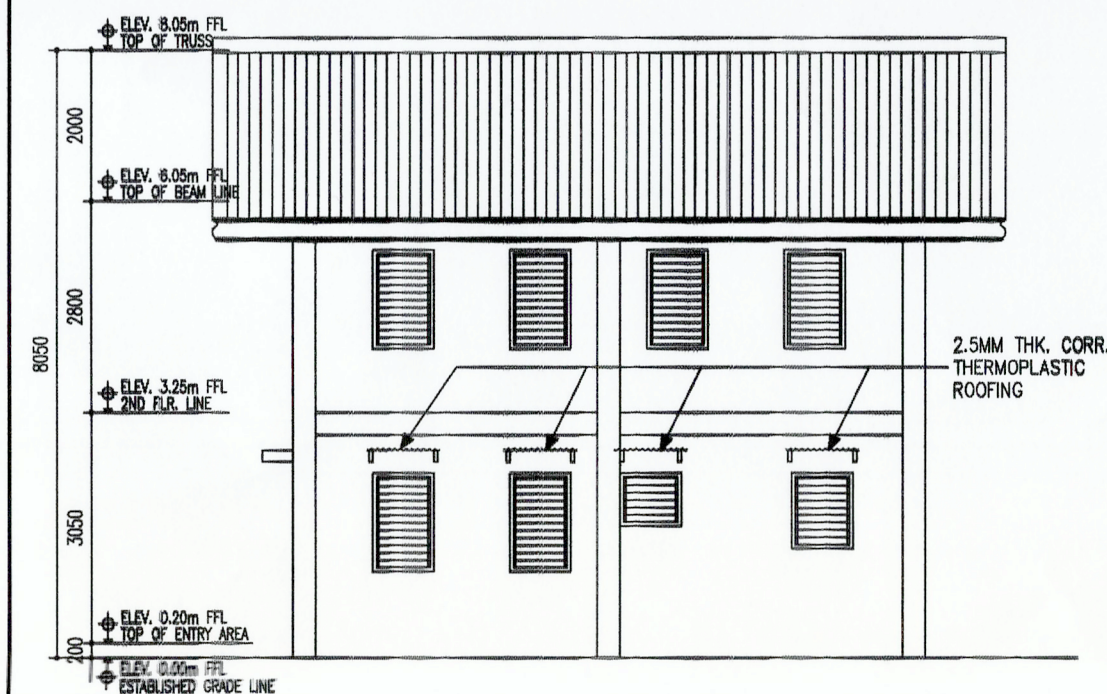

02.3 REAR ELEVATION
SCALE 1:100 METERS

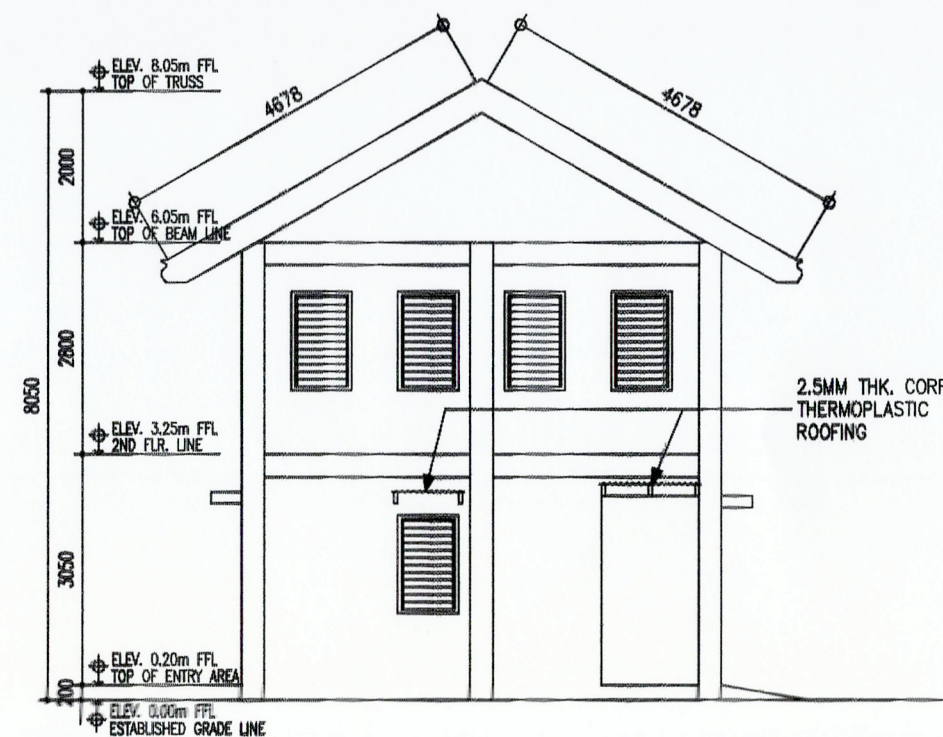

02.4 LEFT SIDE ELEVATION
SCALE 1:100 METERS

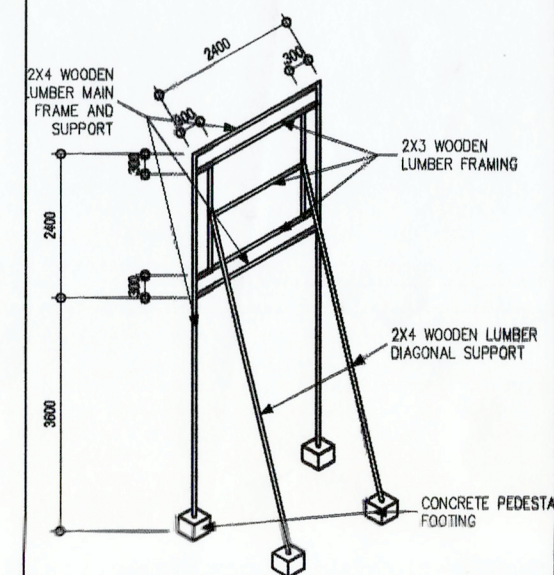

02.5 COA BILLBOARD DETAIL
SCALE 1:100 METERS



PREPARED BY:
[Signature]
VICTOR A. JASPE
ENGINEERING ASSISTANT-A

CHECKED AND REVIEWED BY:
[Signature]
EDEL PETER L. DE LA ROSA
SUPERVISING ENGINEER A

RECOMMENDING APPROVAL BY:
[Signature]
LARA SIMONE L. ABA
ACTING ESD MANAGER

APPROVED BY:
[Signature]
ANALEE G. AGUILA
PORT MANAGER

OWNER:
ANALEE G. AGUILA
PORT MANAGER

PROJECT TITLE:
MAINTENANCE OF ESD TOOLROOM
BUILDING, SASA PORT

LOCATION:
KM. 10, PORT AREA, SASA, DAVAO CITY

REVISIONS
DATE REMARKS
ADDENDUM
NO. DATE
1 10/29/2024
2 10/29/2024

SHEET NO. OF
02 2
CADD BY: VAL
DATE DRAWN: 10/19/2024
DATE UPDATED: 10/29/2024