


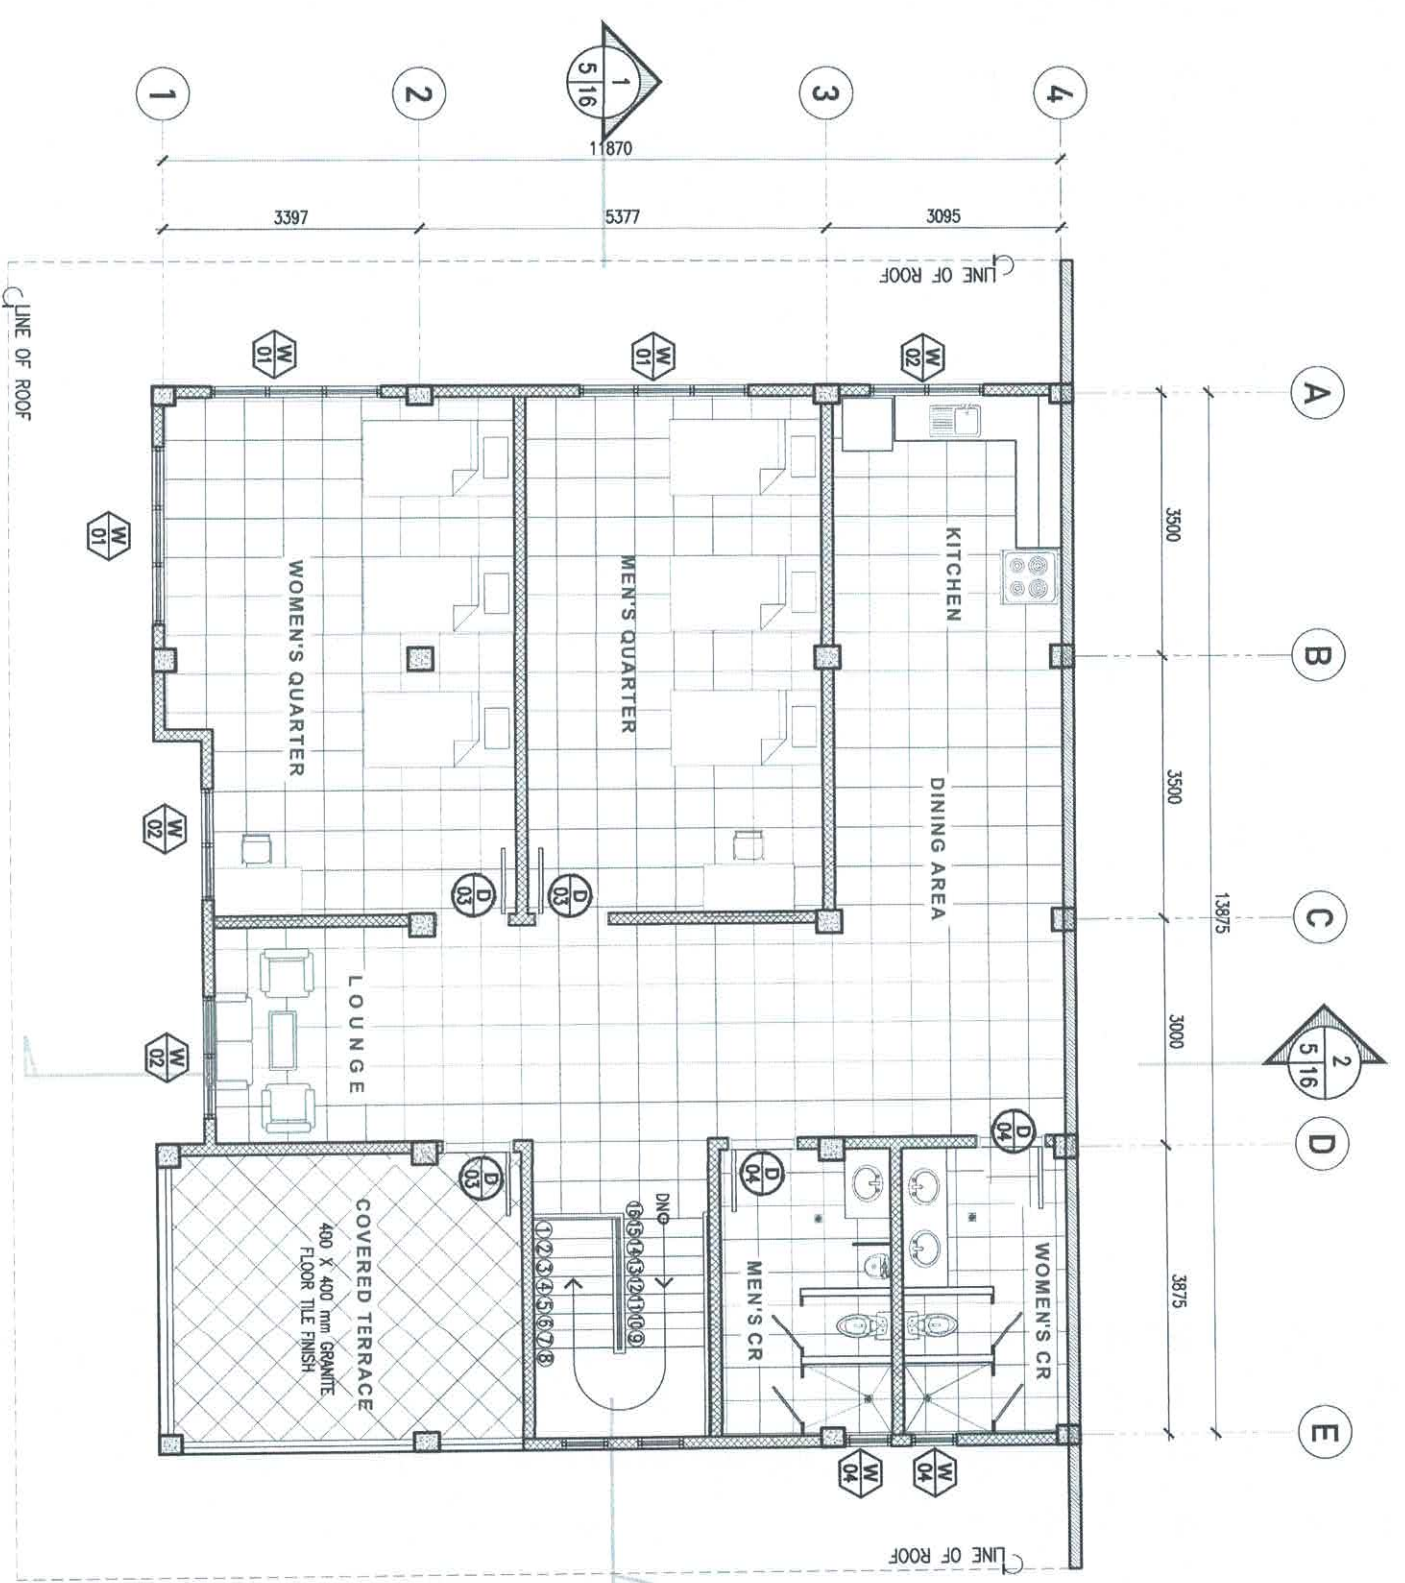

TERMINAL MANAGEMENT OFFICE BUILDING - AS-BUILT  
**SECOND FLOOR PLAN**  
1 SCALE  
1:100mts

PROJECT TITLE: EMERGENCY MAINTENANCE OF ROOFING, CEILING AND ELECTRICAL SYSTEM AT TMO BUILDING



PORT MANAGEMENT OFFICE OF BICOL  
REGIONAL GOVERNMENT CENTER,  
RIMS, LEGAZPI CITY 4500

|                                                               |                                                                              |                                                                                         |                                                                |                                         |
|---------------------------------------------------------------|------------------------------------------------------------------------------|-----------------------------------------------------------------------------------------|----------------------------------------------------------------|-----------------------------------------|
| PREPARED BY<br><b>MA. JULIA A. SALES, uap</b><br>DRAFTSMAN IV | CHECKED/REVIEWED BY<br><b>CHRISTOPHER M. CADAG</b><br>SUPERVISING ENGINEER A | RECOMMENDING APPROVAL<br><b>JOHN S. DE LOS SANTOS</b><br>ACTING DIVISION MANAGER A, ESD | APPROVED<br><b>MA. MAGNOLIA SINSON-REQUENA</b><br>PORT MANAGER | SHEET NO.<br>3<br>16<br>AUGUST 04, 2025 |
|---------------------------------------------------------------|------------------------------------------------------------------------------|-----------------------------------------------------------------------------------------|----------------------------------------------------------------|-----------------------------------------|