


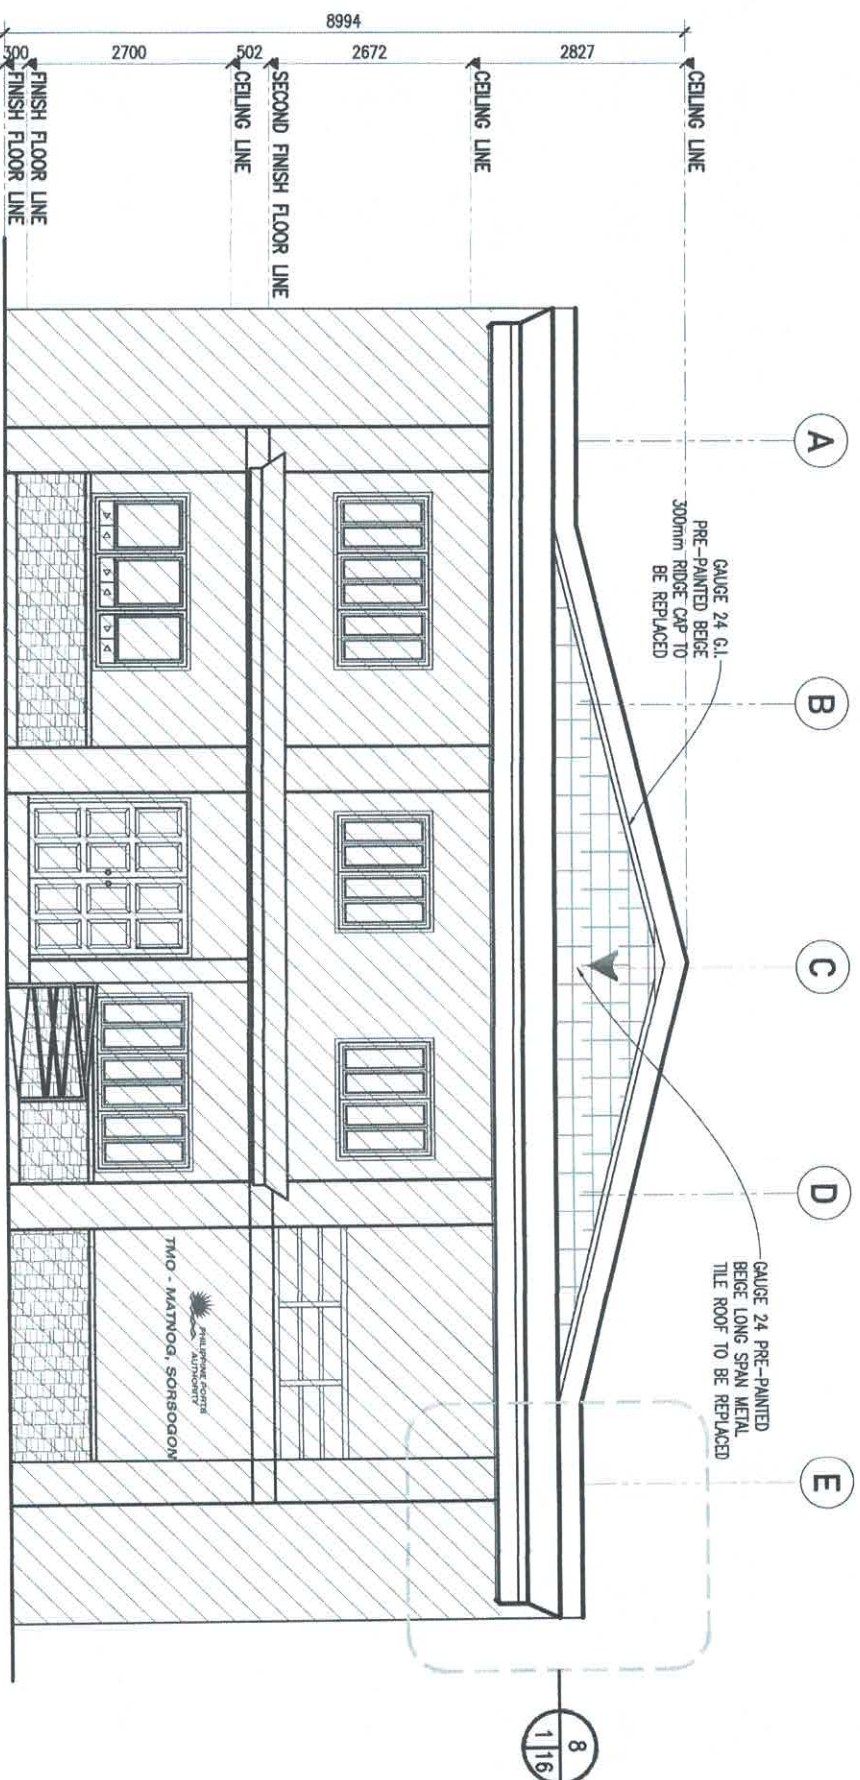

TERMINAL MANAGEMENT OFFICE BUILDING - AS-BUILT
FRONT ELEVATION
1
SCALE
1:100mts

PROJECT TITLE

EMERGENCY MAINTENANCE OF ROOFING, CEILING AND ELECTRICAL SYSTEM AT TMO BUILDING

SHEET NO.



PHILIPPINE
PORTS
AUTHORITY
PORT MANAGEMENT OFFICE OF BICOL
REGIONAL GOVERNMENT CENTER,
RIMS, LEGASHI CITY 4300

PREPARED BY

MA. JULIA A. SALES, uap

DRAFTSMAN IV

CHECKED/REVIEWED BY

CHRISTOPHER M. CADAG

SUPERVISING ENGINEER A

RECOMMENDING APPROVAL

JOHN S. DE LOS SANTOS

ACTING DIVISION MANAGER A, ESO

APPROVED

MA. MAGNOLIA SINSON-REQUEJO

PORT MANAGER

4
16
AUGUST 04, 2025