


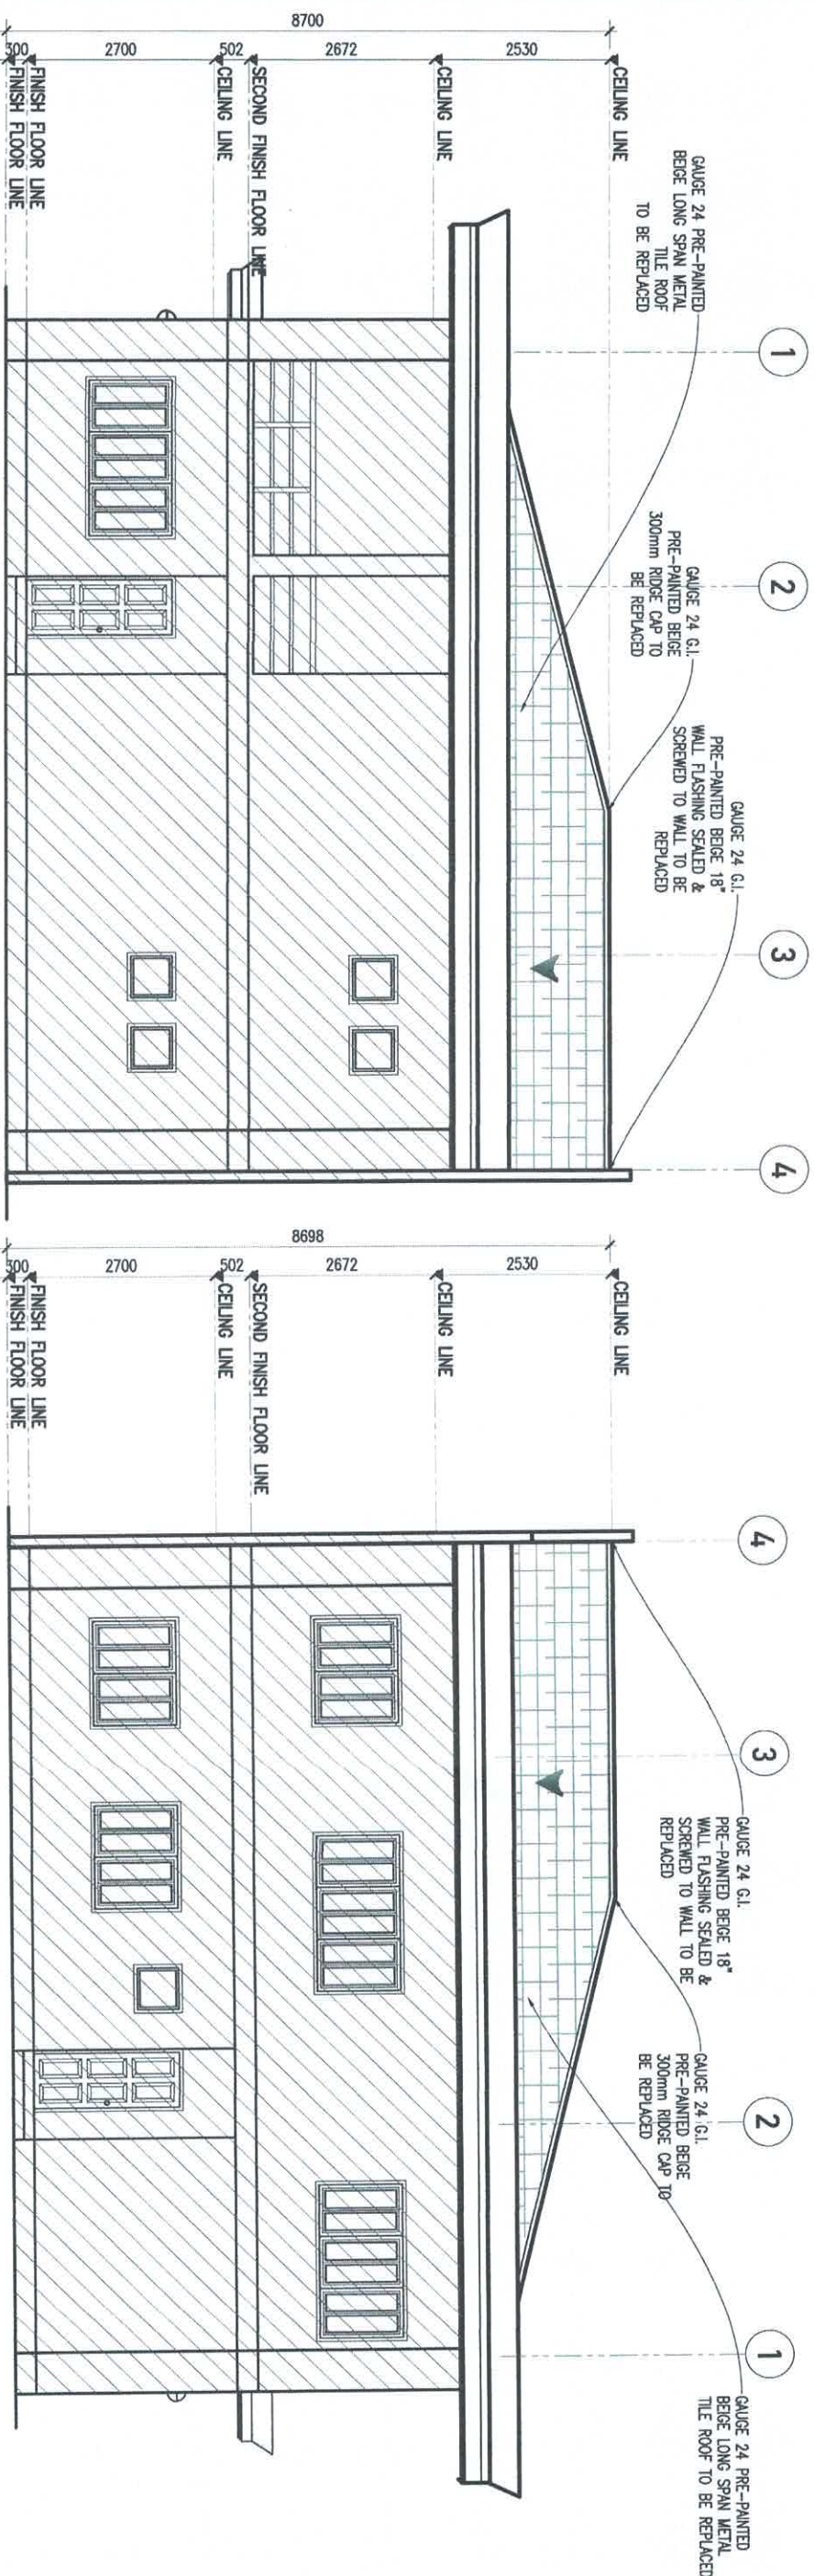

1
SCALE
1:100mts

TERMINAL MANAGEMENT OFFICE BUILDING - AS-BUILT
RIGHT SIDE ELEVATION

2
SCALE
1:100mts

TERMINAL MANAGEMENT OFFICE BUILDING - AS-BUILT
LEFT SIDE ELEVATION

PROJECT TITLE

EMERGENCY MAINTENANCE OF ROOFING, CEILING AND ELECTRICAL SYSTEM AT TMO BUILDING

SHEET NO.



PORT MANAGEMENT OFFICE OF BICOL
REGIONAL COORDINATING CENTER
BANGS, LERAPI CITY 4300

PREPARED BY

MA. JULIA A. SALAS, uap

DRAFTSMAN IV

CHECKED/REVIEWED BY

CHRISTOPHER M. CADAG

SUPERVISING ENGINEER A

RECOMMENDING APPROVAL

JOHN S. DE LOS SANTOS

ACTING DIVISION MANAGER A, ESD

APPROVED

MA. MAGNOLIA SINSON-REQUEJO

PORT MANAGER

5

16

AUGUST 04, 2025